



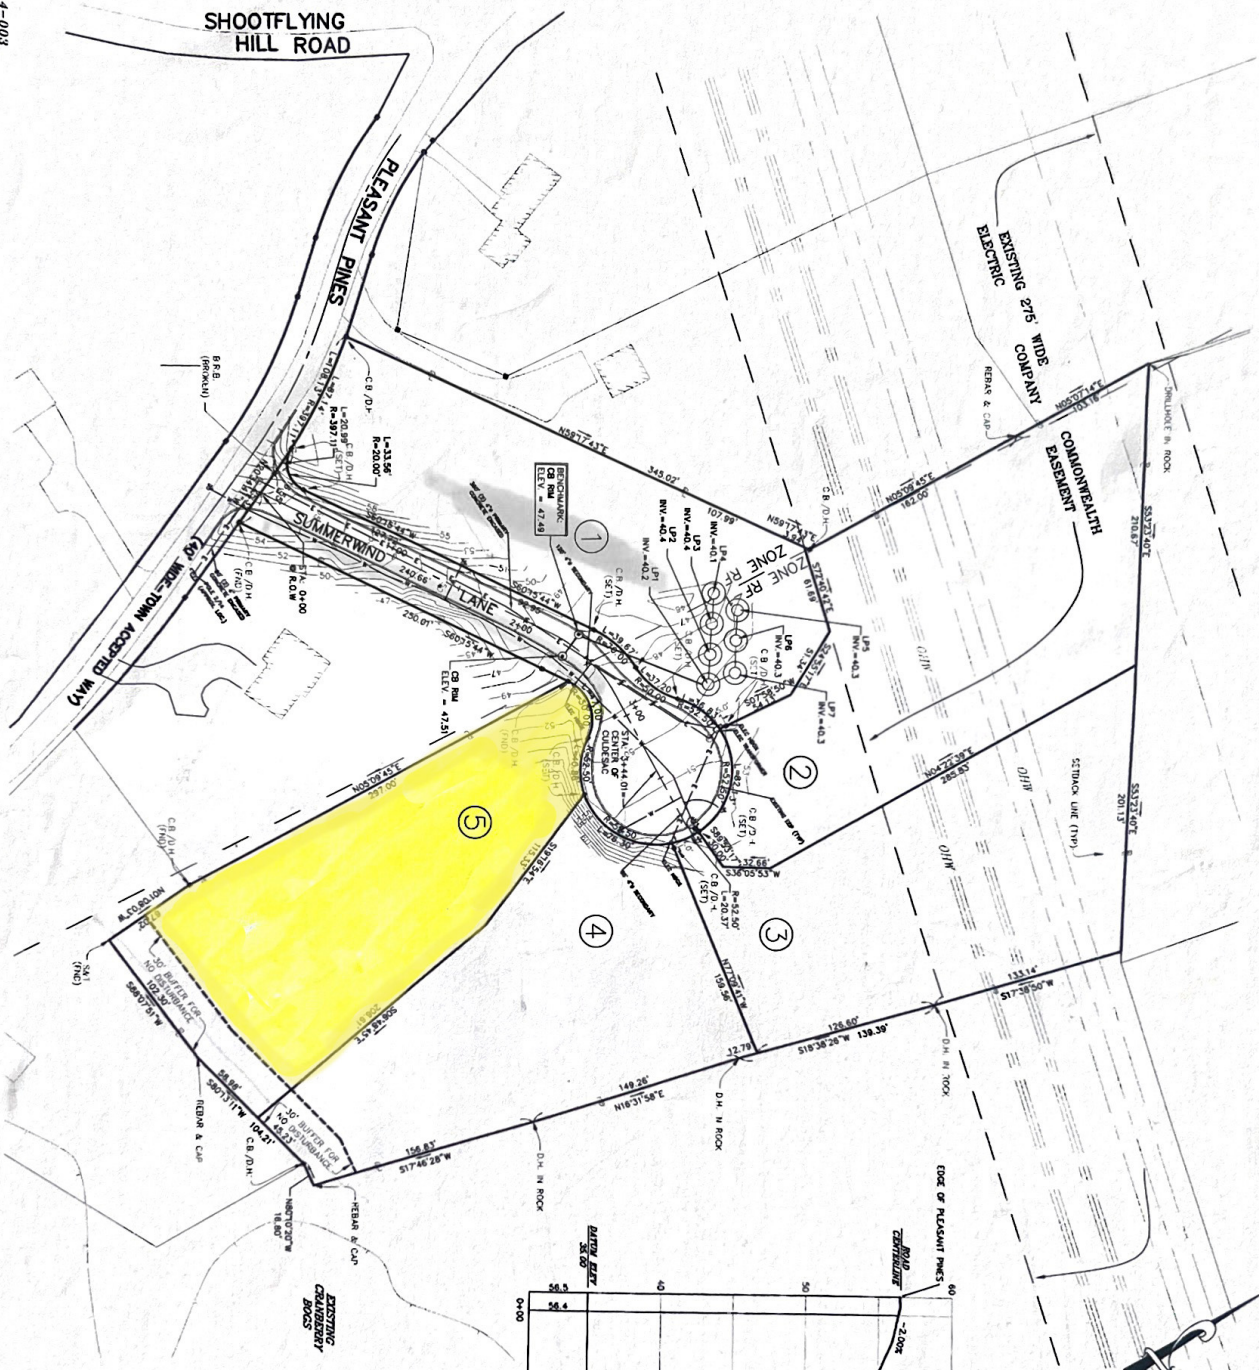


GENERAL NOTES:

1. THE LOCATION OF EXISTING EASEMENTS ARE SHOWN ON THIS PLAN AS CONVEYED BY THE RECORD MAPS AND DEEDS. THE LOCATION OF EXISTING EASEMENTS ARE SHOWN ON THIS PLAN AS CONVEYED BY THE RECORD MAPS AND DEEDS. THE LOCATION OF EXISTING EASEMENTS ARE SHOWN ON THIS PLAN AS CONVEYED BY THE RECORD MAPS AND DEEDS.
2. THE LOCATION OF EXISTING EASEMENTS ARE SHOWN ON THIS PLAN AS CONVEYED BY THE RECORD MAPS AND DEEDS. THE LOCATION OF EXISTING EASEMENTS ARE SHOWN ON THIS PLAN AS CONVEYED BY THE RECORD MAPS AND DEEDS. THE LOCATION OF EXISTING EASEMENTS ARE SHOWN ON THIS PLAN AS CONVEYED BY THE RECORD MAPS AND DEEDS.

LOCUS MAP

SCALE 1"=2000'

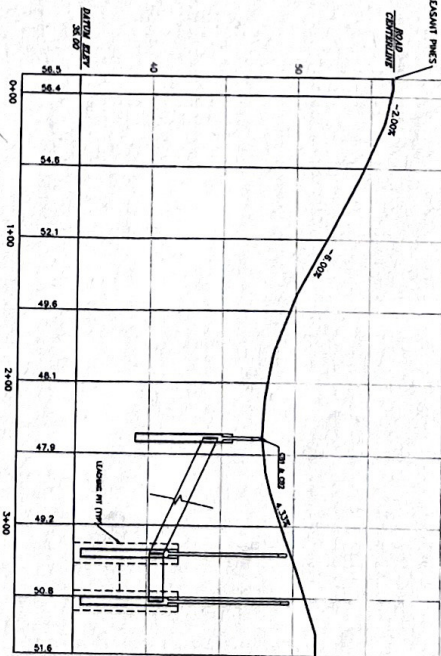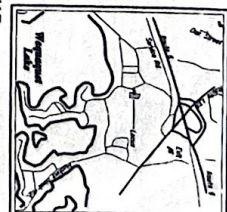


Scale: 1"=40' HORIZONTAL
Scale: 1"=4' VERTICAL

**SUBDIVISION #776
AS-BUILT PLAN
OF LAND IN
WEST BARNSTABLE, MA
SUMMERWIND LANE
OFF PLEASANT PINES**

DATE: APRIL 8, 2014

Scale: 1"=40'

U-52341
DATE: DANIEL A. GALLA, P.E., P.L.S.

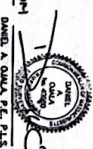

down cape engineering, inc.
civil engineers
land surveyors
339 Main Street (Rte 6A)
YARVOUTHPORT MA 02675